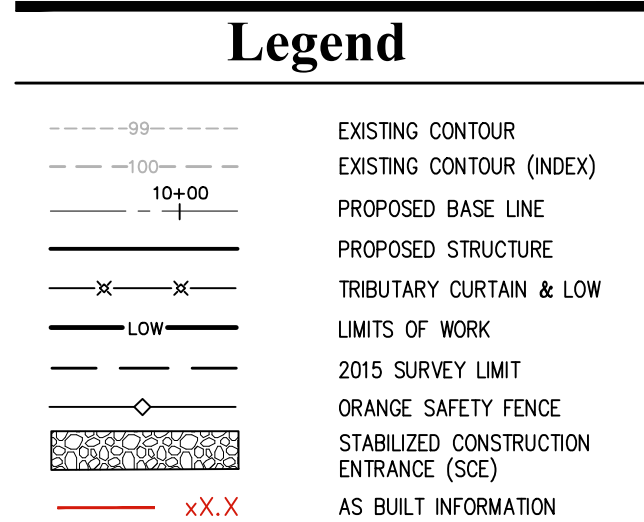


[illegible]

**N.A.S. Patuxent River
Shoreline Repair of
Cedar Point Subreach 2
Project CA#N40080-15-2-0003
St. Mary's County, Maryland**

As Built

Drawing Number	
AB-1	
Sheet	of
1	1
Project Number	