

Chesapeake Bay

PHASE 2

LIMITS OF ASBUILT SURVEY

PROPOSED PIPE EXTENSION

AS-BUILT CERTIFICATION

I HEREBY CERTIFY THAT TO THE BEST OF MY KNOWLEDGE THAT THIS AS-BUILT TRULY REPRESENTS EXISTING FIELD CONDITIONS INCLUDING BUT NOT LIMITED TO SPOT ELEVATIONS, CONTOURS AND LIMITS OF REVETMENT.

Larry L. Mann 3-12-18
LARRY L. MANN
REGISTERED PROPERTY LINE
SURVEYOR MD REG. NO. 469
EXPIRATION DATE: 01-02-2019

GENERAL NOTES

- HORIZONTAL DATUM: NAD 83/91
- VERTICAL DATUM: NAVD 88
- THE LIMITS OF ASBUILT SURVEY AS SHOWN HEREON IS BASED ON A FIELD RUN SURVEY BY SOLTESZ ON JANUARY 11, 2018. GIS CONTOURS AND ALL OTHER DATA SHOWN HEREON WAS PROVIDED BY OTHERS.
- NO BOUNDARY SURVEY WAS PROVIDED OR REQUIRED FOR THIS SURVEY.
- EXISTING NON-FUNCTIONING INLETS COVERED WITH FILTER CLOTH, FILLED, AND MACHINE COMPACTED. PIPE EXTENSIONS NOT INSTALLED.

LEGEND

- LIMITS OF ASBUILT SURVEY
- EXISTING (GIS) CONTOURS
- SILT FENCING
- ASBUILT SPOT ELEVATIONS
- ASBUILT REVETMENT
- ORANGE SAFETY FENCE
- SOLTESZ TRAVERSE STATION

AS-BUILT SURVEY
CONSTRUCTED STONE REVETMENT


1. HORIZONTAL DATUM: NAD 83/91
2. VERTICAL DATUM: NAVD 88
3. THE LIMITS OF ASBUILT SURVEY AS SHOWN HEREON IS BASED ON A FIELD RUN SURVEY BY SOLTESZ ON JANUARY 11, 2018. GIS CONTOURS AND ALL OTHER DATA SHOWN HEREON WAS PROVIDED BY OTHERS.
4. NO BOUNDARY SURVEY WAS PROVIDED OR REQUIRED FOR THIS SURVEY.
5. EXISTING NON-FUNCTIONING INLETS COVERED WITH FILTER CLOTH, FILLED, AND MACHINE COMPACTED. PIPE EXTENSIONS NOT INSTALLED.

	LIMITS OF ASBUILT SURVEY
	EXISTING (GIS) CONTOURS
SF	SILT FENCING
+ 6.11	ASBUILT SPOT ELEVATIONS
	ASBUILT REVETMENT
//	ORANGE SAFETY FENCE
△ TRAV	SOILTESZ TRAVERSE STATION

I HEREBY CERTIFY THAT TO THE BEST OF MY KNOWLEDGE THAT THIS AS-BUILT TRULY REPRESENTS EXISTING FIELD CONDITIONS INCLUDING BUT NOT LIMITED TO SPOT ELEVATIONS, CONTOURS AND LIMITS OF REVETMENT.


Larry L. Mann 3-12-18
LARRY L. MANN DATE
REGISTERED PROPERTY LINE
SURVEYOR MD REG. NO. 469
EXPIRATION DATE: 01-02-2019

SOLTESZ TRAVERSE
#1010 N.255548.962 E.1487831.327 ELEV=5.37
#1011 N.224840.597 E.1487230.778 ELEV=9.86
#1012 N.224320.781 E.1486861.748 ELEV=6.11

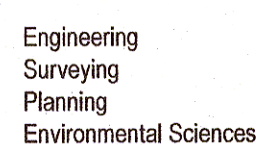

WALDORF OFFICE
401 Post Office Road, Suite 103
Waldorf, MD 20602
P. 301.870.2166 F. 301.870.2884

Rockville
Lanham
Waldorf
Leonardtwn
Frederick
Soltesz DC, LLC

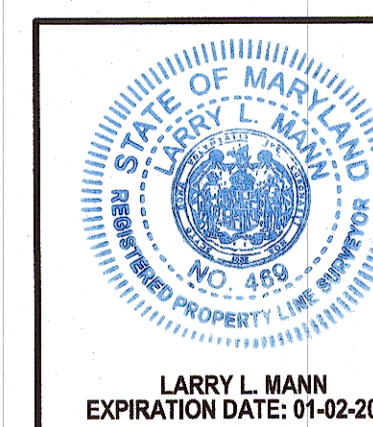

**CEDAR POINT SHORELINE STABILIZATION
AT NAS PATUXENT RIVER
CONTRACT #N40080-15-2-0009
ST MARY'S COUNTY, MARYLAND**



SHEET 1
1

PROJECT N
3361-07-0

S:\33610702\Survey\Sheet Files\Sketches\As-built_Phase 2 Revetment.dgn Scale= 50.0000 sf / in. User= fkephart PLTdrv= PDF_Color_150.pltcfg Pentbl= TEXT_SUB.tbl 3/12/2018 8:01:30